




WATER RISER DIAGRAM 11
NO SCALE P-400

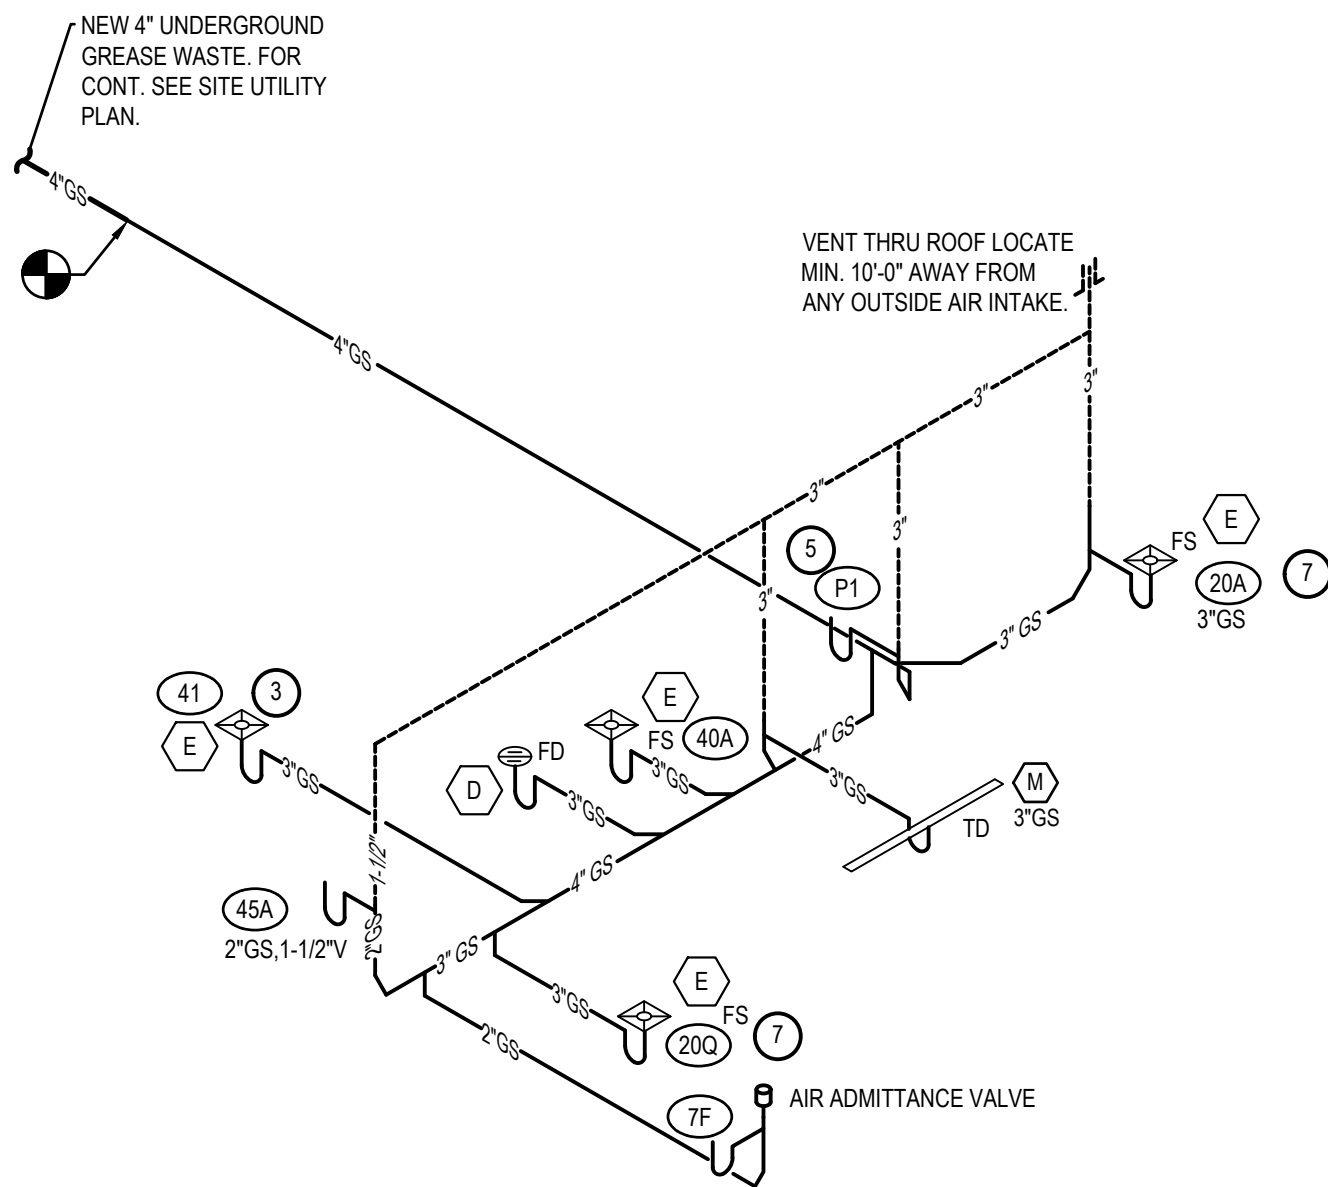

WASTE AND VENT RISER DIAGRAM 9
NO SCALE P-400

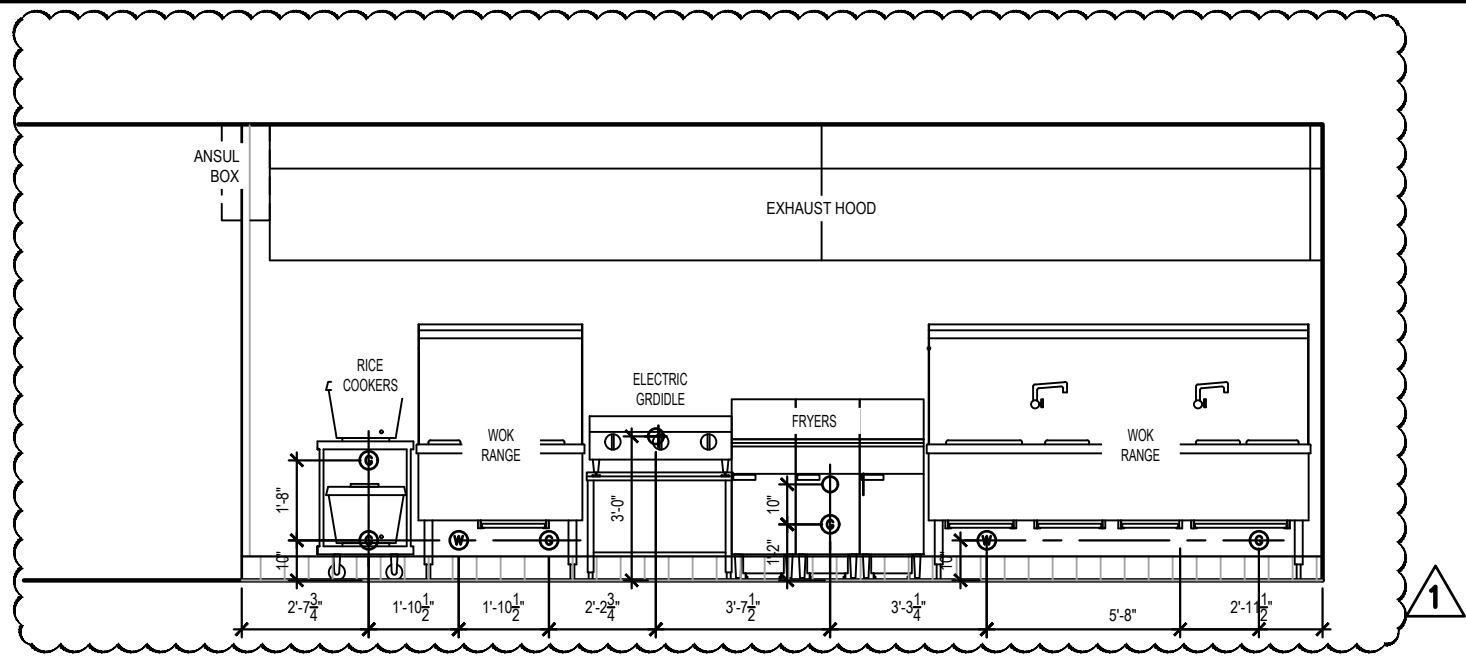

GAS COOKLINE ELEVATION 4
NO SCALE P-400

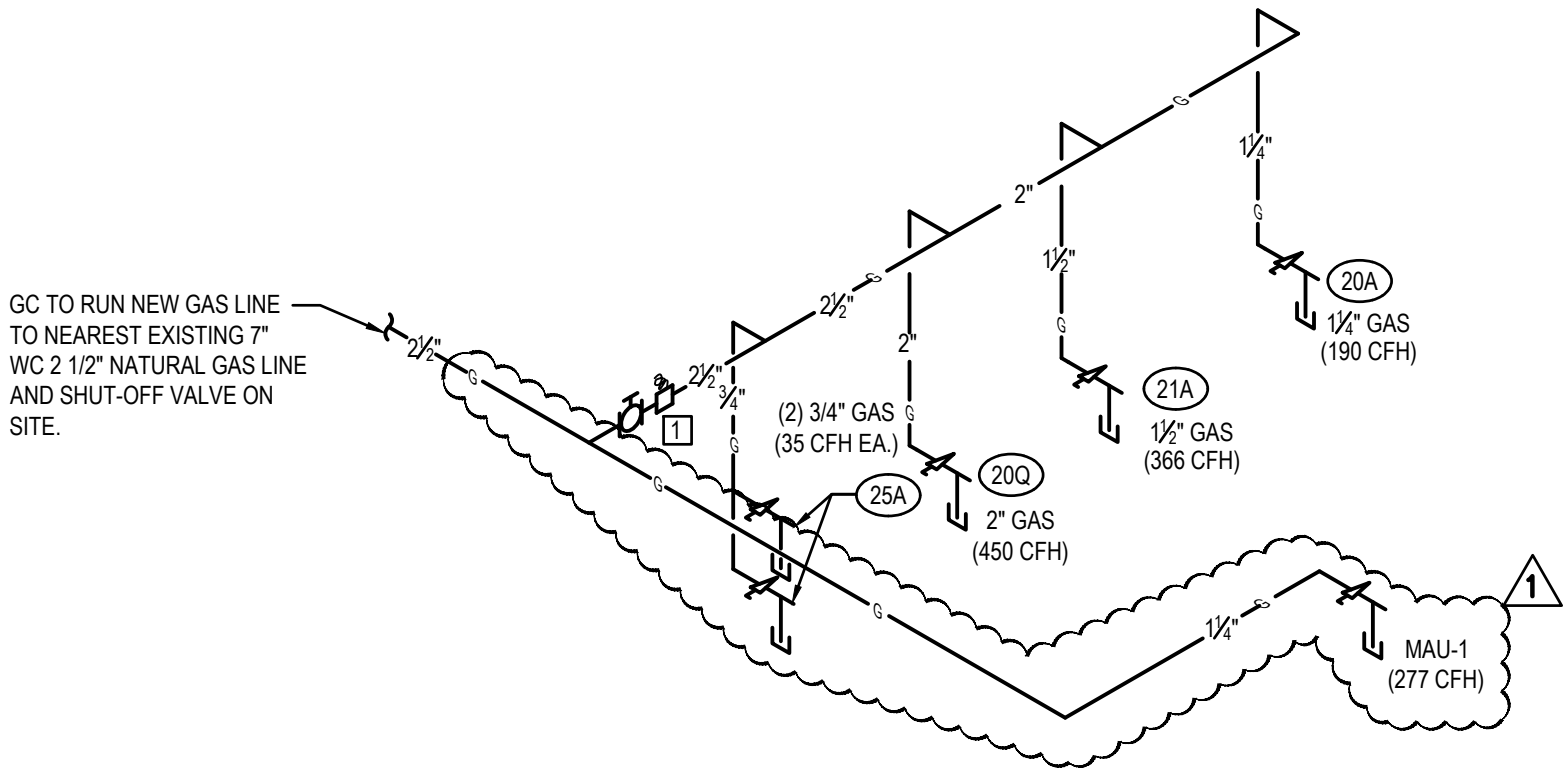

GAS RISER CODED NOTE:
[1] COORDINATE PRV WITH LEAVING PRESSURE FROM GAS METER

GAS RISER DIAGRAM 3
NO SCALE P-400

GAS EQUIPMENT SCHEDULE

ITEM	QTY	EQUIPMENT	CFH	
			EACH	TOTAL
20A	1	CHINESE RANGE	190	190
20Q	1	CHINESE RANGE	450	450
21G	3	DEEP FRYER	122	366
25A	2	RICE COOKER	35	70
MAU-1	1	MAKE-UP AIR UNIT	277	277
TOTAL				1,353

LOW PRESSURE NATURAL GAS CALCULATION
SIZED PER 2018 IFGC TABLE 402.4(2)
TOTAL DEVELOPED LENGTH: 200'
TOTAL LOAD: 1,353CFH

NOTE:
DO NOT RUN ANY PIPING
HORIZONTAL IN WALL SPACE



PANDA RESTAURANT GROUP INC.
1683 Walnut Grove Ave.
Rosemead, California
91770
Telephone: 626.799.9898
Facsimile: 626.372.8288

All ideas, designs, arrangement and plans indicated, or represented by this drawing are the property of Panda Express Inc. and were created for use on this specific project. None of these ideas, designs, arrangements or plans may be used by or disclosed to any person, firm, or corporation without the written permission of Panda Express Inc.

REVISIONS:
[1] PLAN REVIEW COMMENTS 03/26/2021

ISSUE DATE:
1 95% SUBMITTAL 01/11/2020
2 100% SUBMITTAL 04/16/2021
3 100% RESUBMITTAL 05/14/2021
4 FINAL SUBMITTAL 06/08/2021

DRAWN BY: MRM

PANDA PROJECT #: D7395
ARCH PROJECT #:



MARSHALL & BOLLWERK
ENGINEERING, INC.
8881 Highway 88, Suite 400
Woodstock, Ga. 30189
p: (678) 795-0333, f: (678) 325-4559
e: mbe@mbeng.net



PANDA EXPRESS

ROBINS AFB SHOPPING CENTER
ROBINS AFB, GA

P-400

WATER, GAS WASTE &
VENT RISER DIAGRAMS

BID SET - 2021/06/28